



Gaithersburg
A CHARACTER COUNTS! CITY

NOTICE OF ADDRESS ASSIGNMENT (CORRECTION)

In accordance with Section 19(27) of the City of Gaithersburg Charter, effective on **May 21, 2012**, addresses have been assigned to the following proposed retail spaces in Building C-1 in the Crown Farm subdivision, as approved by Site Plan **SP-11-0012**. These addresses are currently served by the **20878** zip code, which can be verified by contacting the United States Postal Service. This address letter supersedes Letter AA-12-002 for building C-1, which used the incorrect block range for Ellington Boulevard.

Please retain this letter as an official document and file with other property documents, deeds, or leases. Montgomery County Emergency Services, U.S. post offices, and local utility offices will be notified of this action; however, the owner/resident should verify that all appropriate agencies are correctly listing their address. A copy of the approved address maps are attached for your reference.

Please add the address numbers to the exterior of the building or in another conspicuous place. The size requirements set forth by the Montgomery County Fire Code for the posting of address numbers on buildings are a minimum of five (5) inches in height for single family houses and six (6) inches in height for commercial, industrial, multi-family residential or other uses. Numbers should be plain block numerals (not script or written numbers), need to be placed on a contrasting background, and must be clearly visible from the public or private street on which the address faces. The assignment of unit addresses within a building is reviewed and approved by the City of Gaithersburg.

If you have any further questions please do not hesitate to call Kirk Eby at (301) 258-6330. Thank you for your cooperation in this matter.

ELLINGTON BOULEVARD – Map AA-12-004-1 and AA-12-002-4 (corrected)		
Plat 15 Crown Farm (County Plat 24382)	Existing State Tax Account ID	Assigned Address
Future Lot 4, Block A – Building C1, Retail Space 9	160903686865	301 Ellington Boulevard (primary address)
Future Lot 4, Block A – Building C1, Retail Space 10	160903686865	305 Ellington Boulevard
Future Lot 4, Block A – Building C1, Retail Space 11	160903686865	309 Ellington Boulevard
Future Lot 4, Block A – Building C1, Retail Space 12	160903686865	313 Ellington Boulevard
Future Lot 4, Block A – Building C1, Retail Space 13	160903686865	317 Ellington Boulevard
Future Lot 4, Block A – Building C1, Retail Space 14	160903686865	321 Ellington Boulevard
Future Lot 4, Block A – Building C1, Retail Space 15	160903686865	325 Ellington Boulevard
Future Lot 4, Block A – Building C1, Retail Space 16	160903686865	329 Ellington Boulevard

Sincerely,


J. Kirk Eby, GIS Planner
Planning and Code Administration
Letter written and sent May 21, 2012

City of Gaithersburg • 31 South Summit Avenue, Gaithersburg, Maryland 20877-2098
301-258-6330 • FAX 301-948-6149 • TTY 301-258-6430 • cityhall@gaitersburgmd.gov • www.gaithersburgmd.gov


MAYOR
Sidney A. Katz

COUNCIL MEMBERS
Jud Ashman
Cathy C. Drzyzgula
Henry F. Maraffa, Jr.
Michael A. Sesma
Ryan Spiegel

CITY MANAGER
Angel L. Jones

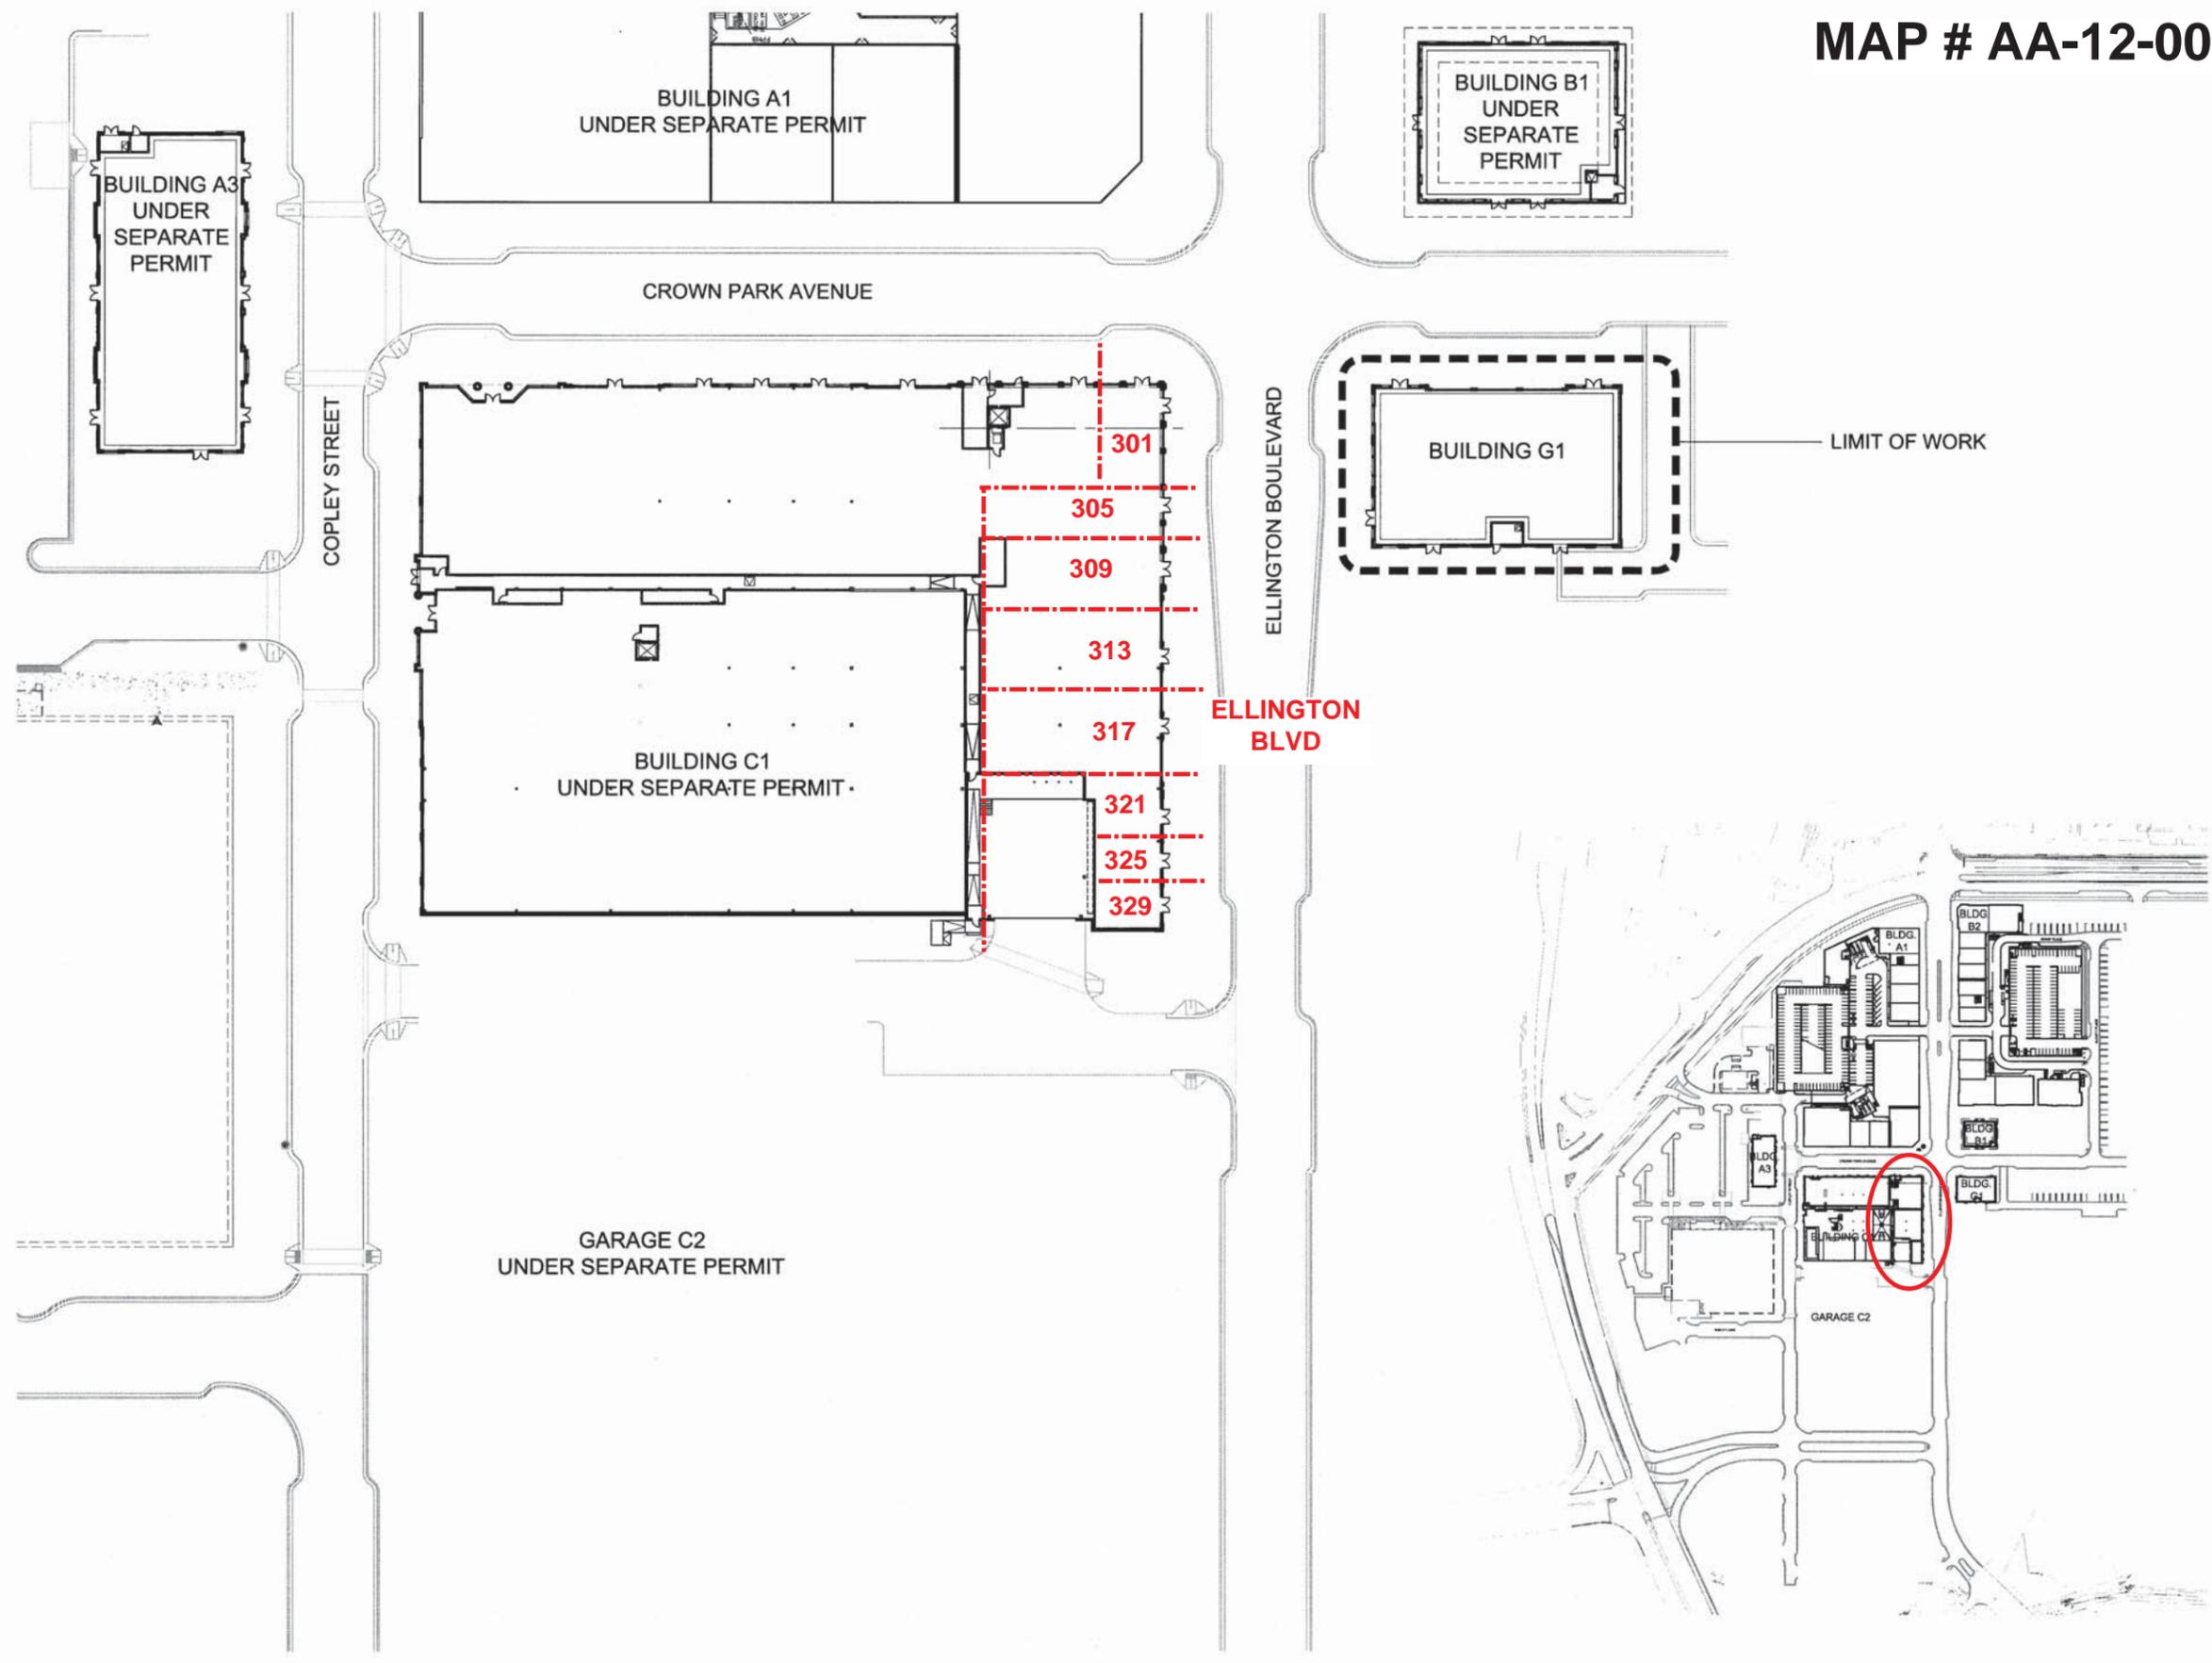

2 SITE PLAN
SCALE: 1/32"=1'-0"

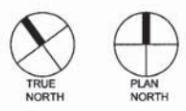

1 OVERALL SITE PLAN
SCALE: 1"=200'-0"



BROWN CRAIG TURNER
executive architect
one charles center
100 north charles street | 18th floor
Baltimore, MD 21201
t 410.837.2727
f 410.837.7447
www.bctarchitects.com

DAVID M. SCHWARZ ARCHITECTS
design architect
1707 L Street N.W., Suite 400
Washington, D.C. 20036
t 202.862.0777
f 202.331.0507

CARROLL ENGINEERING, INC.
structural | consultants
215 Schilling Circle, Suite 102
Hunt Valley, MD 21031
t 410.785.7423
f 410.771.1313

E&S CONSTRUCTION ENGINEERS, INC.
mechanical | plumbing | electrical consultants
4326 Mountain Road
Pasadena, MD 21122
t 410.360.2280
f 410.360.2290

client | owner
JBG ROSENFELD RETAIL
4445 Willard Avenue, Suite 700
Chevy Chase, MD 20815
t 301.657.0700
f 301.657.9850
www.jbgr.com



PROFESSIONAL CERTIFICATION: I HEREBY CERTIFY THAT THESE DOCUMENTS WERE PREPARED BY ME, AND THAT I AM A FULLY LICENSED ARCHITECT UNDER THE LAWS OF THE STATE OF MARYLAND.
REGISTRATION # 13112
EXPIRATION: 4/30/2014

revisions


No.	Date	Title

OVERALL SITE PLAN


Issue Date: 5.1.12 Scale: NOTED

20.01

**MAP # AA-12-002-4
(corrected 05-21-2012)**

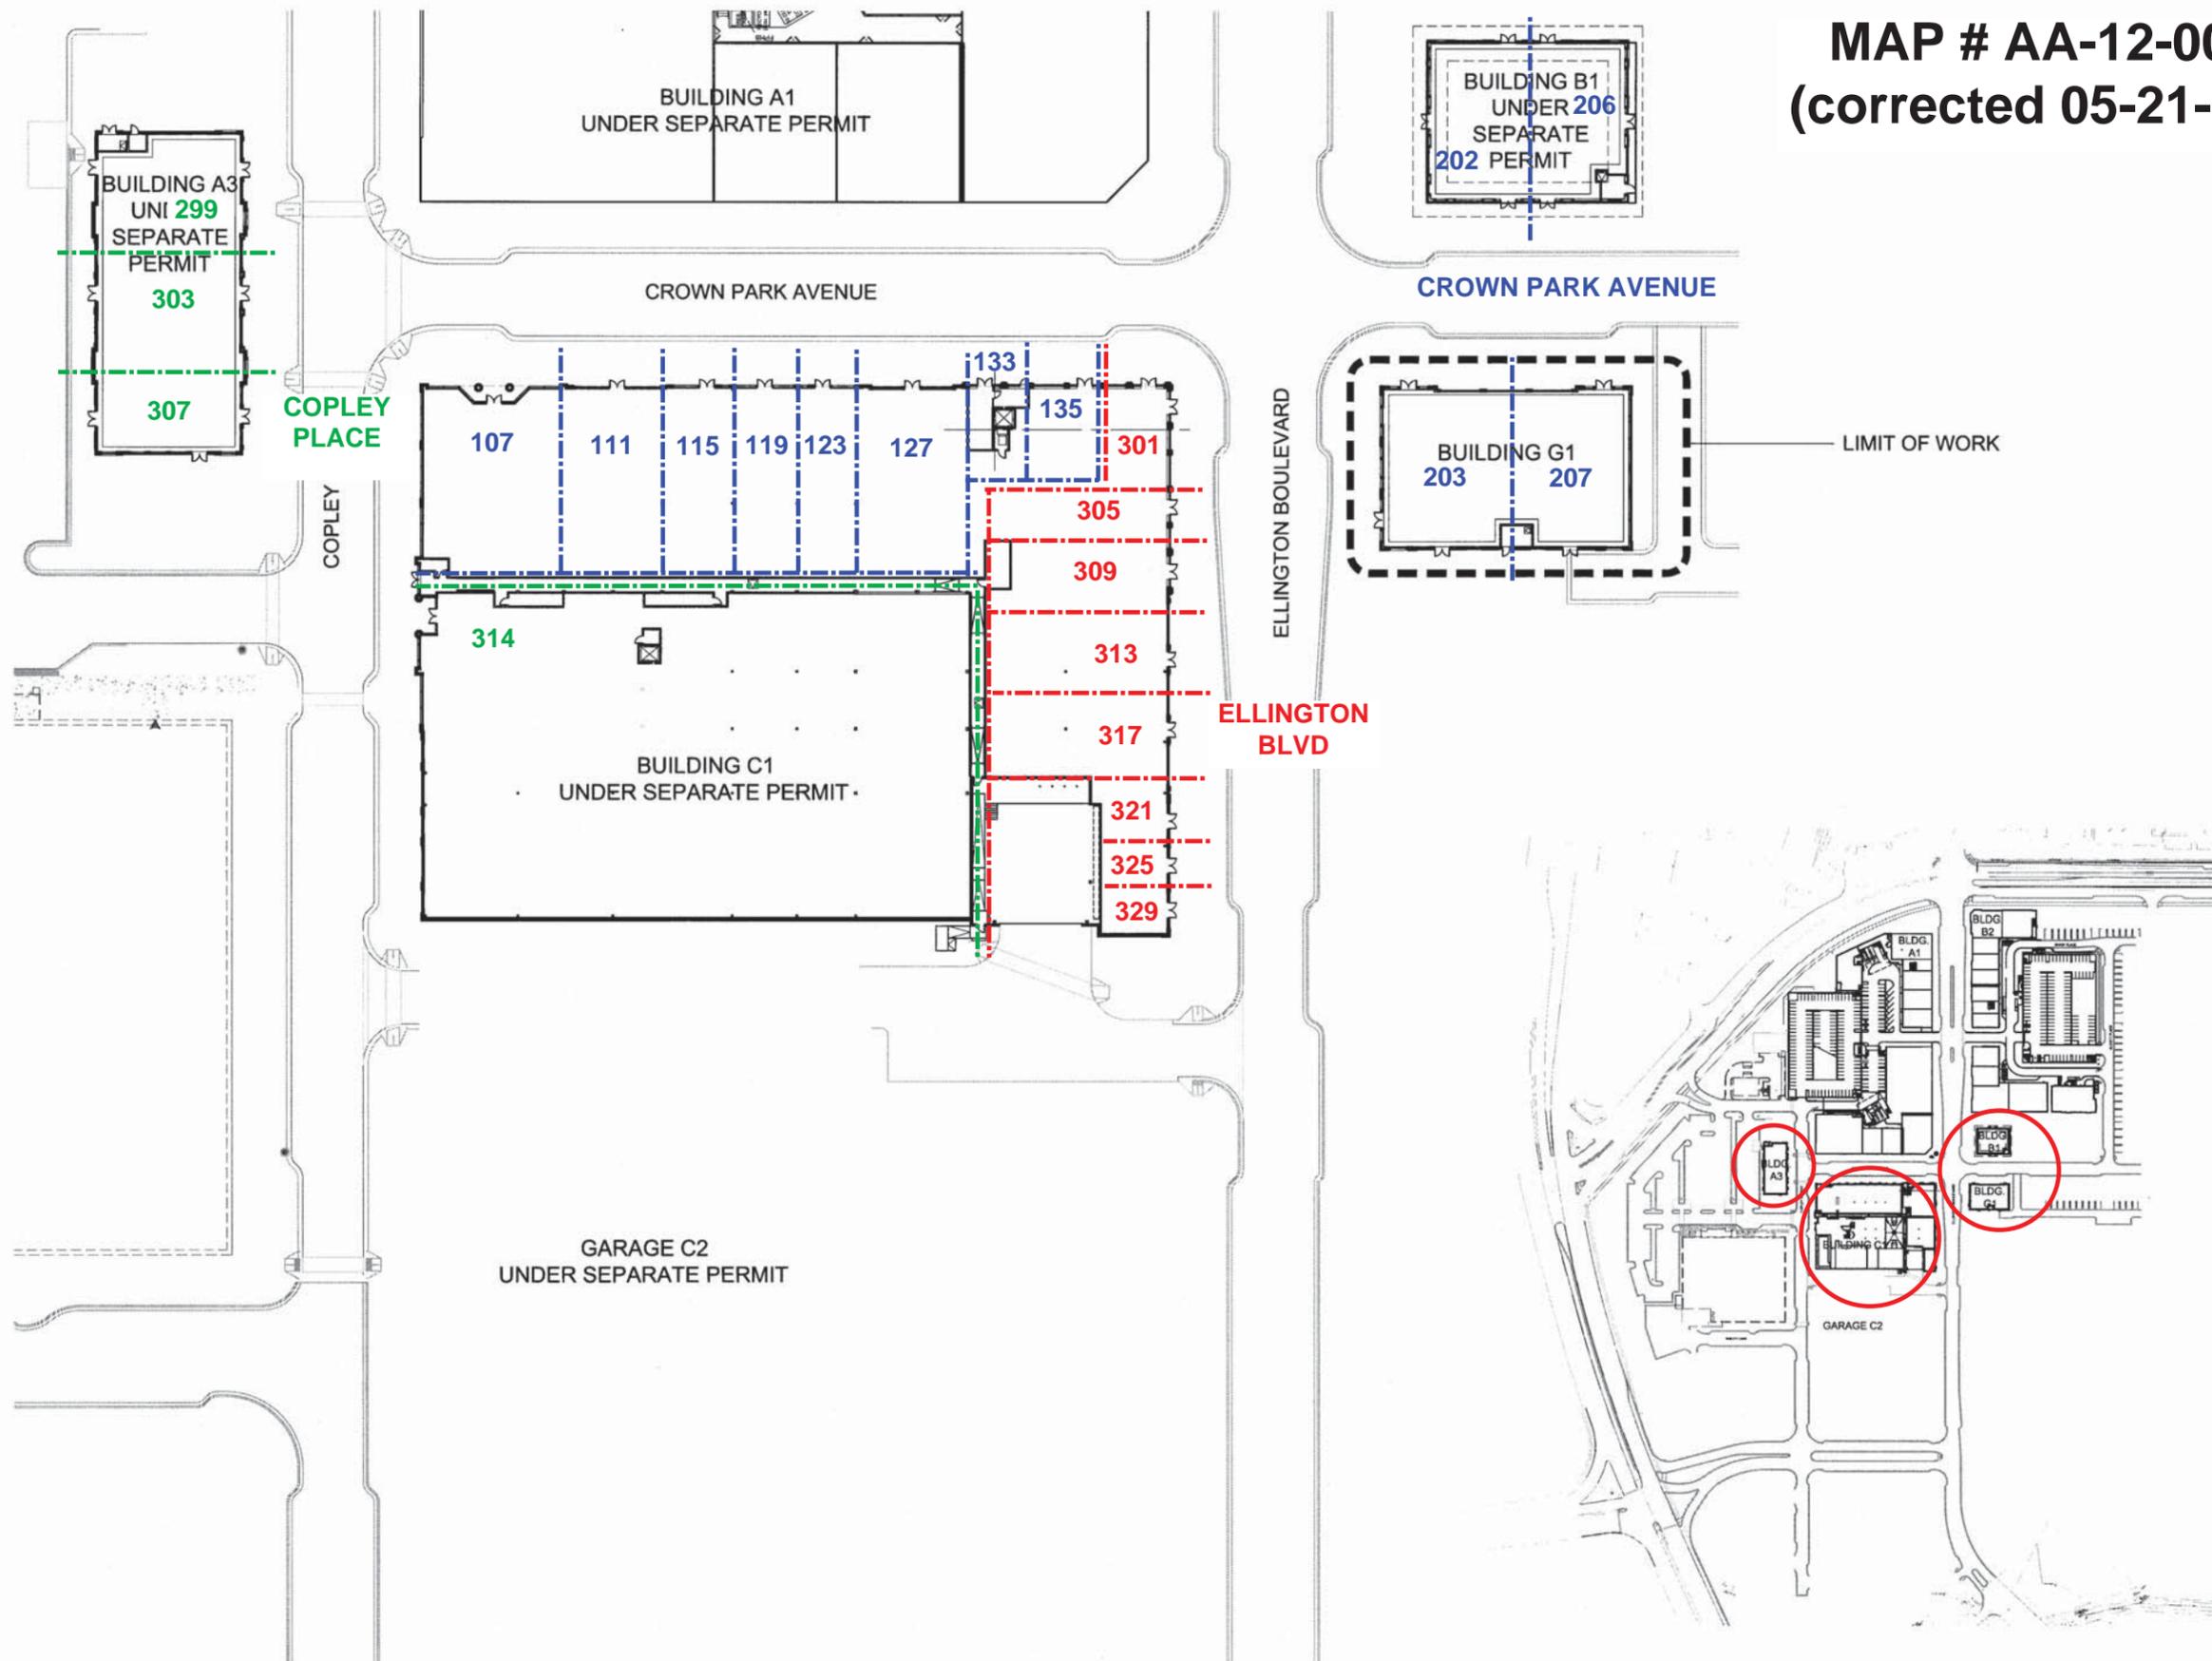

2 SITE PLAN
SCALE: 1/32"=1'-0"

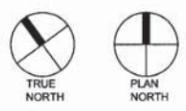

1 OVERALL SITE PLAN
SCALE: 1"=200'-0"




executive architect
BROWN CRAIG TURNER
one charles center
100 north charles street | 18th floor
Baltimore, MD 21201
t 410.837.2727
f 410.837.7447
www.bctarchitects.com

design architect
DAVID M. SCHWARZ ARCHITECTS
1707 L Street N.W., Suite 400
Washington, D.C. 20036
t 202.862.0777
f 202.331.0507

structural | consultants
CARROLL ENGINEERING, INC.
215 Schilling Circle, Suite 102
Hunt Valley, MD 21031
t 410.785.7423
f 410.771.1313

mechanical | plumbing | electrical consultants
E&S CONSTRUCTION ENGINEERS, INC.
4326 Mountain Road
Pasadena, MD 21122
t 410.360.2280
f 410.360.2290

project
DOWNTOWN CROWN BUILDING G1
client | owner
JBG ROSENFELD RETAIL
4445 Willard Avenue, Suite 700
Chevy Chase, MD 20815
t 301.657.0700
f 301.657.9850
www.jbgr.com

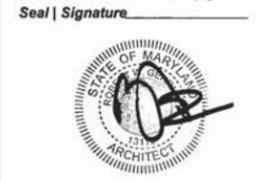

PROFESSIONAL CERTIFICATION: I HEREBY CERTIFY THAT THESE DOCUMENTS WERE PREPARED BY ME, AND THAT I AM A FULLY LICENSED ARCHITECT UNDER THE LAWS OF THE STATE OF MARYLAND.
REGISTRATION # 13112
EXPIRATION: 4/30/2014

revisions

No.	Date	Title

OVERALL SITE PLAN

Issue Date: 5.1.12 Scale: NOTED

20.01